

E-441	
SERVICE NAME :	STRIPPER REBOILER
TYPE :	BEM (Vert.)
SIZE :	750 ID x 3.847 TL/106 m ²
DP(S/T) :	4.5/2 Kg/cm ²
DT(S/T) :	170/135 °C
MATERIAL :	C.S./316L.S.S.

C-441	
SERVICE NAME :	METHYL-ACETATE STRIPPER
TYPE :	Sieve Tray
SIZE :	1300 ID x 13.700 TL/19 m ²
DP(S/T) :	2 kg/cm ² G / 140 °C
MATERIAL :	316L.S.S.


E-442	
SERVICE NAME :	STRIPPER CONDENSER
TYPE :	BEM (Vert.)
SIZE :	600 ID x 4.543 TL/86 m ²
DP(S/T) :	FV-8/2 Kg/cm ² G
DT(S/T) :	75/120 °C
MATERIAL :	C.S./316L.S.S.

V-442	
SERVICE NAME :	STRIPPER REFLUX DRUM
TYPE :	Vert.
SIZE :	1200 ID x 2.200 TL/2.9 m ²
DP(S/T) :	2 kg/cm ² G / 110 °C
MATERIAL :	316L.S.S.

E-443-1/2	
SERVICE NAME :	STRIPPER BOTTOM COOLER
TYPE :	BEM (Horiz.)
SIZE :	700 ID x 6.664 TL/162X2 m ²
DP(S/T) :	FV-8/8 Kg/cm ² G
DT(S/T) :	75/135 °C
MATERIAL :	C.S./316L.S.S.

E-446 (E-601B)	
SERVICE NAME :	CONDENSATE HEAT RECOVERY EXCHANGER
TYPE :	BEM (Horiz.)
SIZE :	800 ID x 5.894 TL/135 m ²
DP(S/T) :	11/9 Kg/cm ² G
DT(S/T) :	130/195 °C
MATERIAL :	304S.S./304S.S.

NOTES
1. TO DRAIN RECOVERY SYSTEM SEE EFD-984

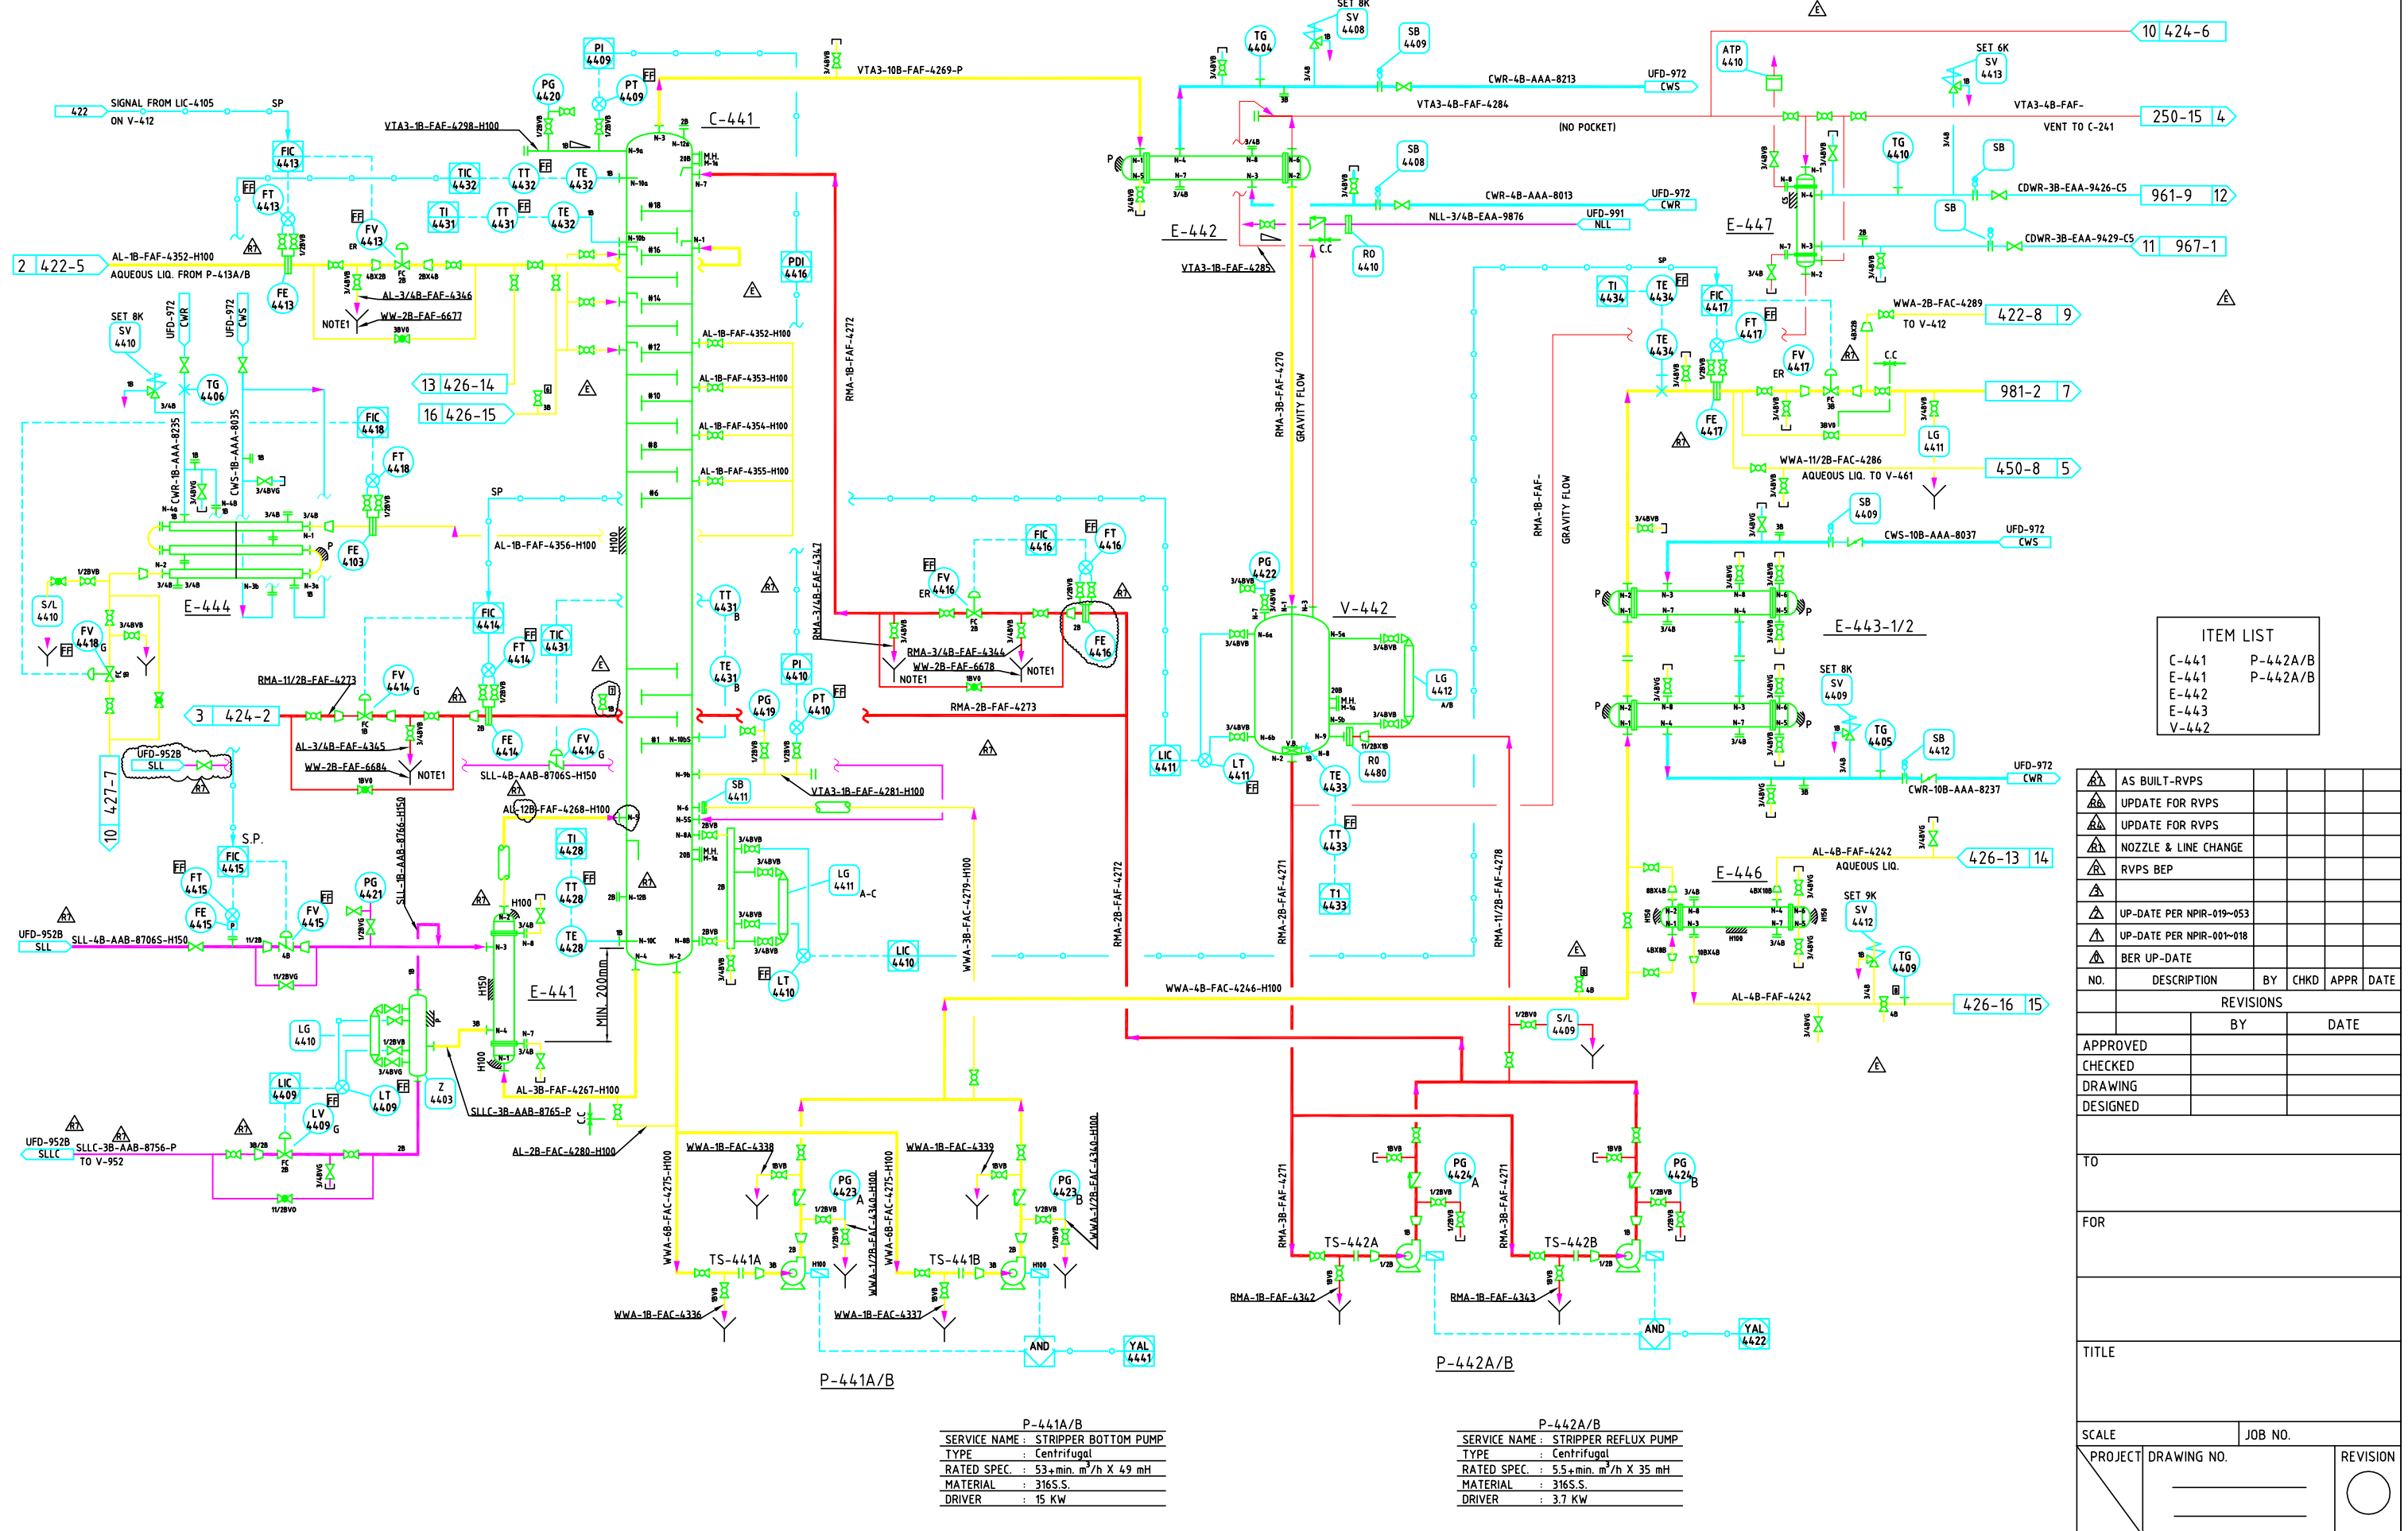

ITEM LIST	
C-441	P-442A/B
E-441	P-442A/B
E-442	
E-443	
V-442	

AS BUILT-RVPS				
UPDATE FOR RVPS				
UPDATE FOR RVPS				
NOZZLE & LINE CHANGE				
RVPS BEP				
UP-DATE PER NPRI-019-053				
UP-DATE PER NPRI-001-018				
BER UP-DATE				
NO.	DESCRIPTION	BY	CHKD	APPR
REVISIONS				
		BY		DATE
APPROVED				
CHECKED				
DRAWING				
DESIGNED				
TO				
FOR				
TITLE				
SCALE		JOB NO.		
PROJECT	DRAWING NO.			REVISION